
SUITE: 1400 RSF: 4,645


AS-BUILT CONFIGURATION

OFFICES	11
RECEPTION	1
CONFERENCE ROOMS	2
KITCHEN	1
OPEN WORK AREA	N/A

Not to scale, furniture and appliances not included

KEY PLAN

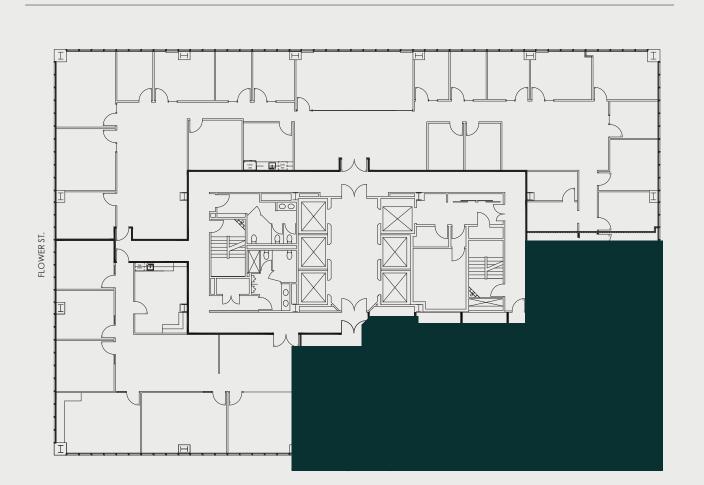

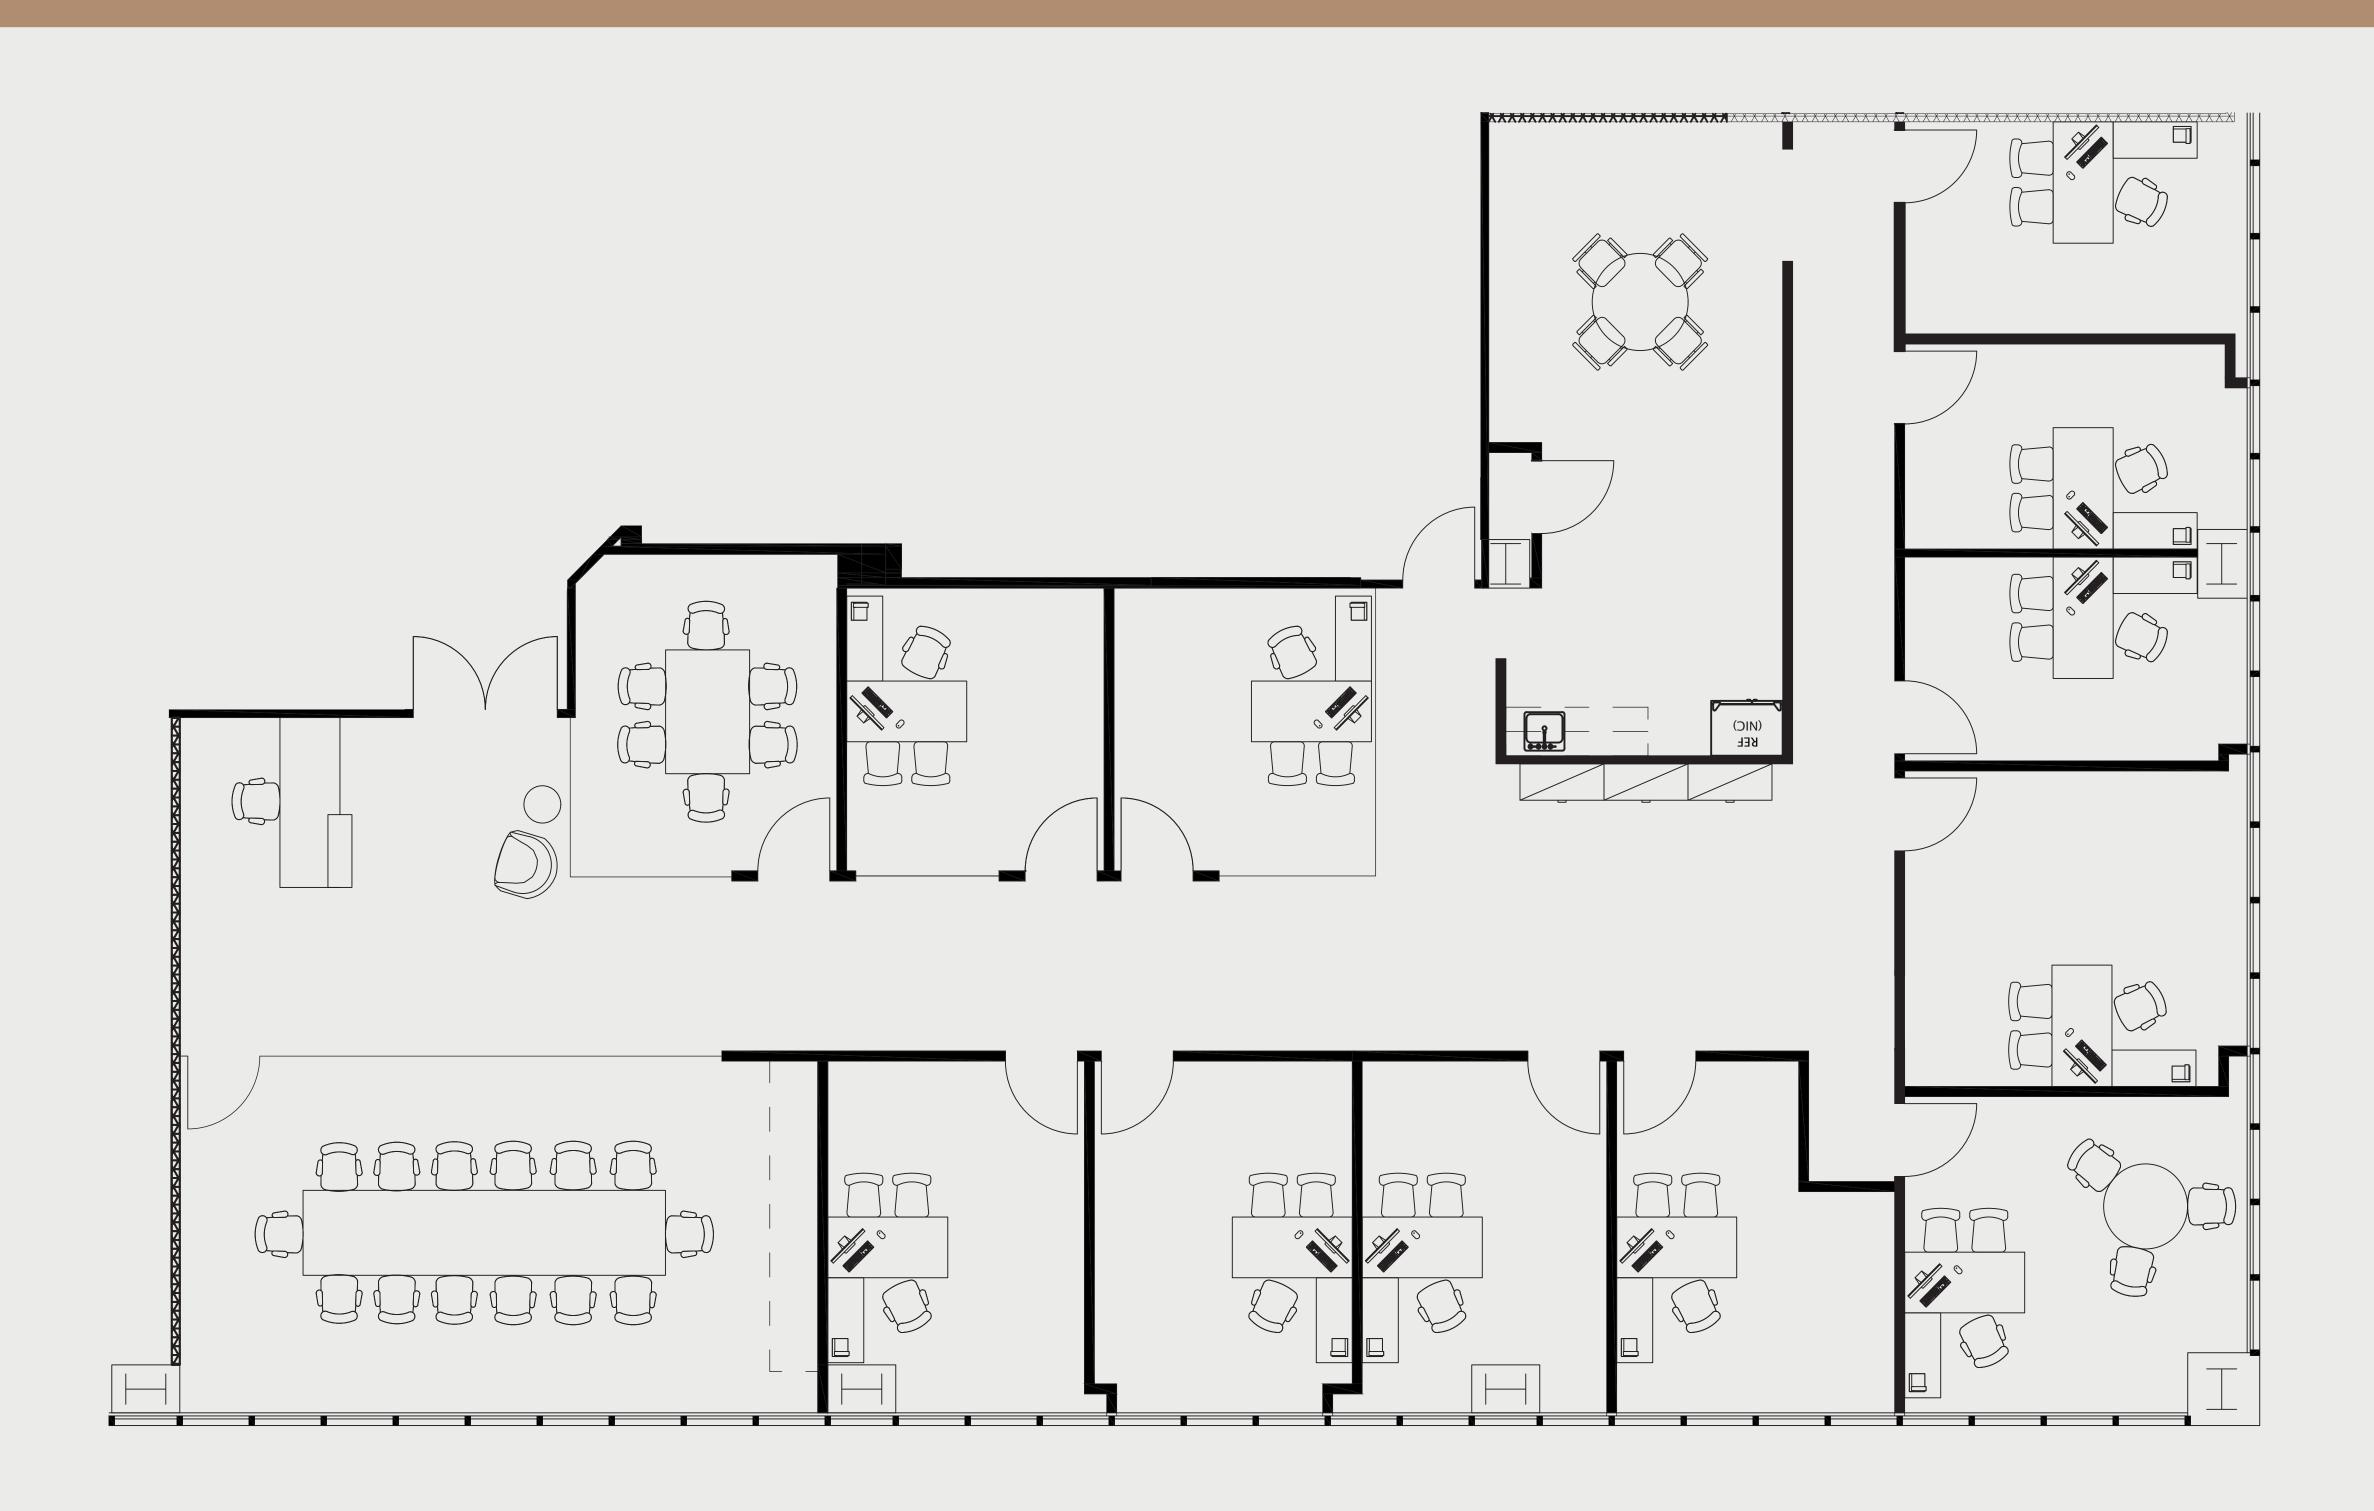

For leasing information please contact: USALEASING@ONNI.COM (213) 629-2041





