SUITE: 1450


RSF: 3,177

AS-BUILT CONFIGURATION

RECEPTION	1
PRIVATE OFFICES	4
CONFERENCE ROOMS	2
KITCHEN	1
OPEN WORK AREA	+/-

KEY PLAN:

Not to scale, furniture and appliances not included

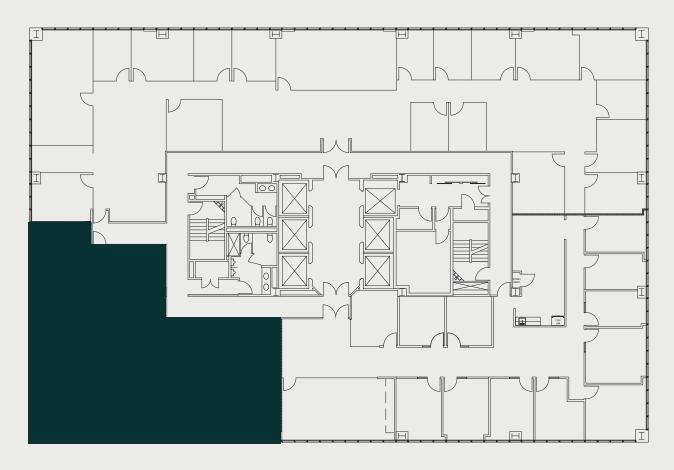

For leasing information please contact: USALEASING@ONNI.COM (213) 629-2041

