SUITE: 1550 RSF: 2,106


AS-BUILT CONFIGURATION


OFFICES	4
RECEPTION	1
CONFERENCE ROOMS	1
KITCHEN	1
OPEN WORK AREA	+/-

- 4

Not to scale, furniture and appliances not included

KEY PLAN

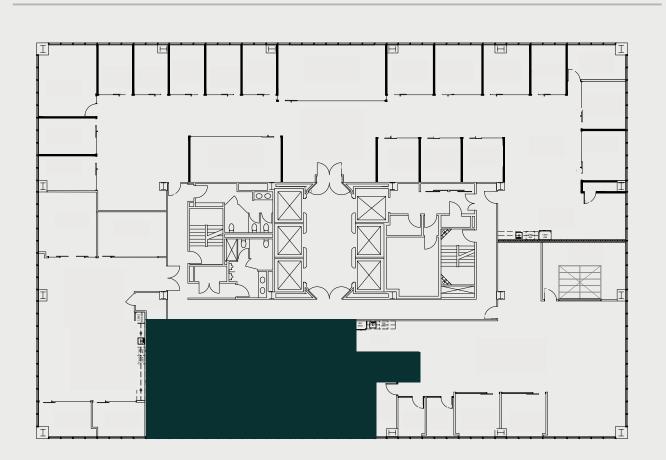

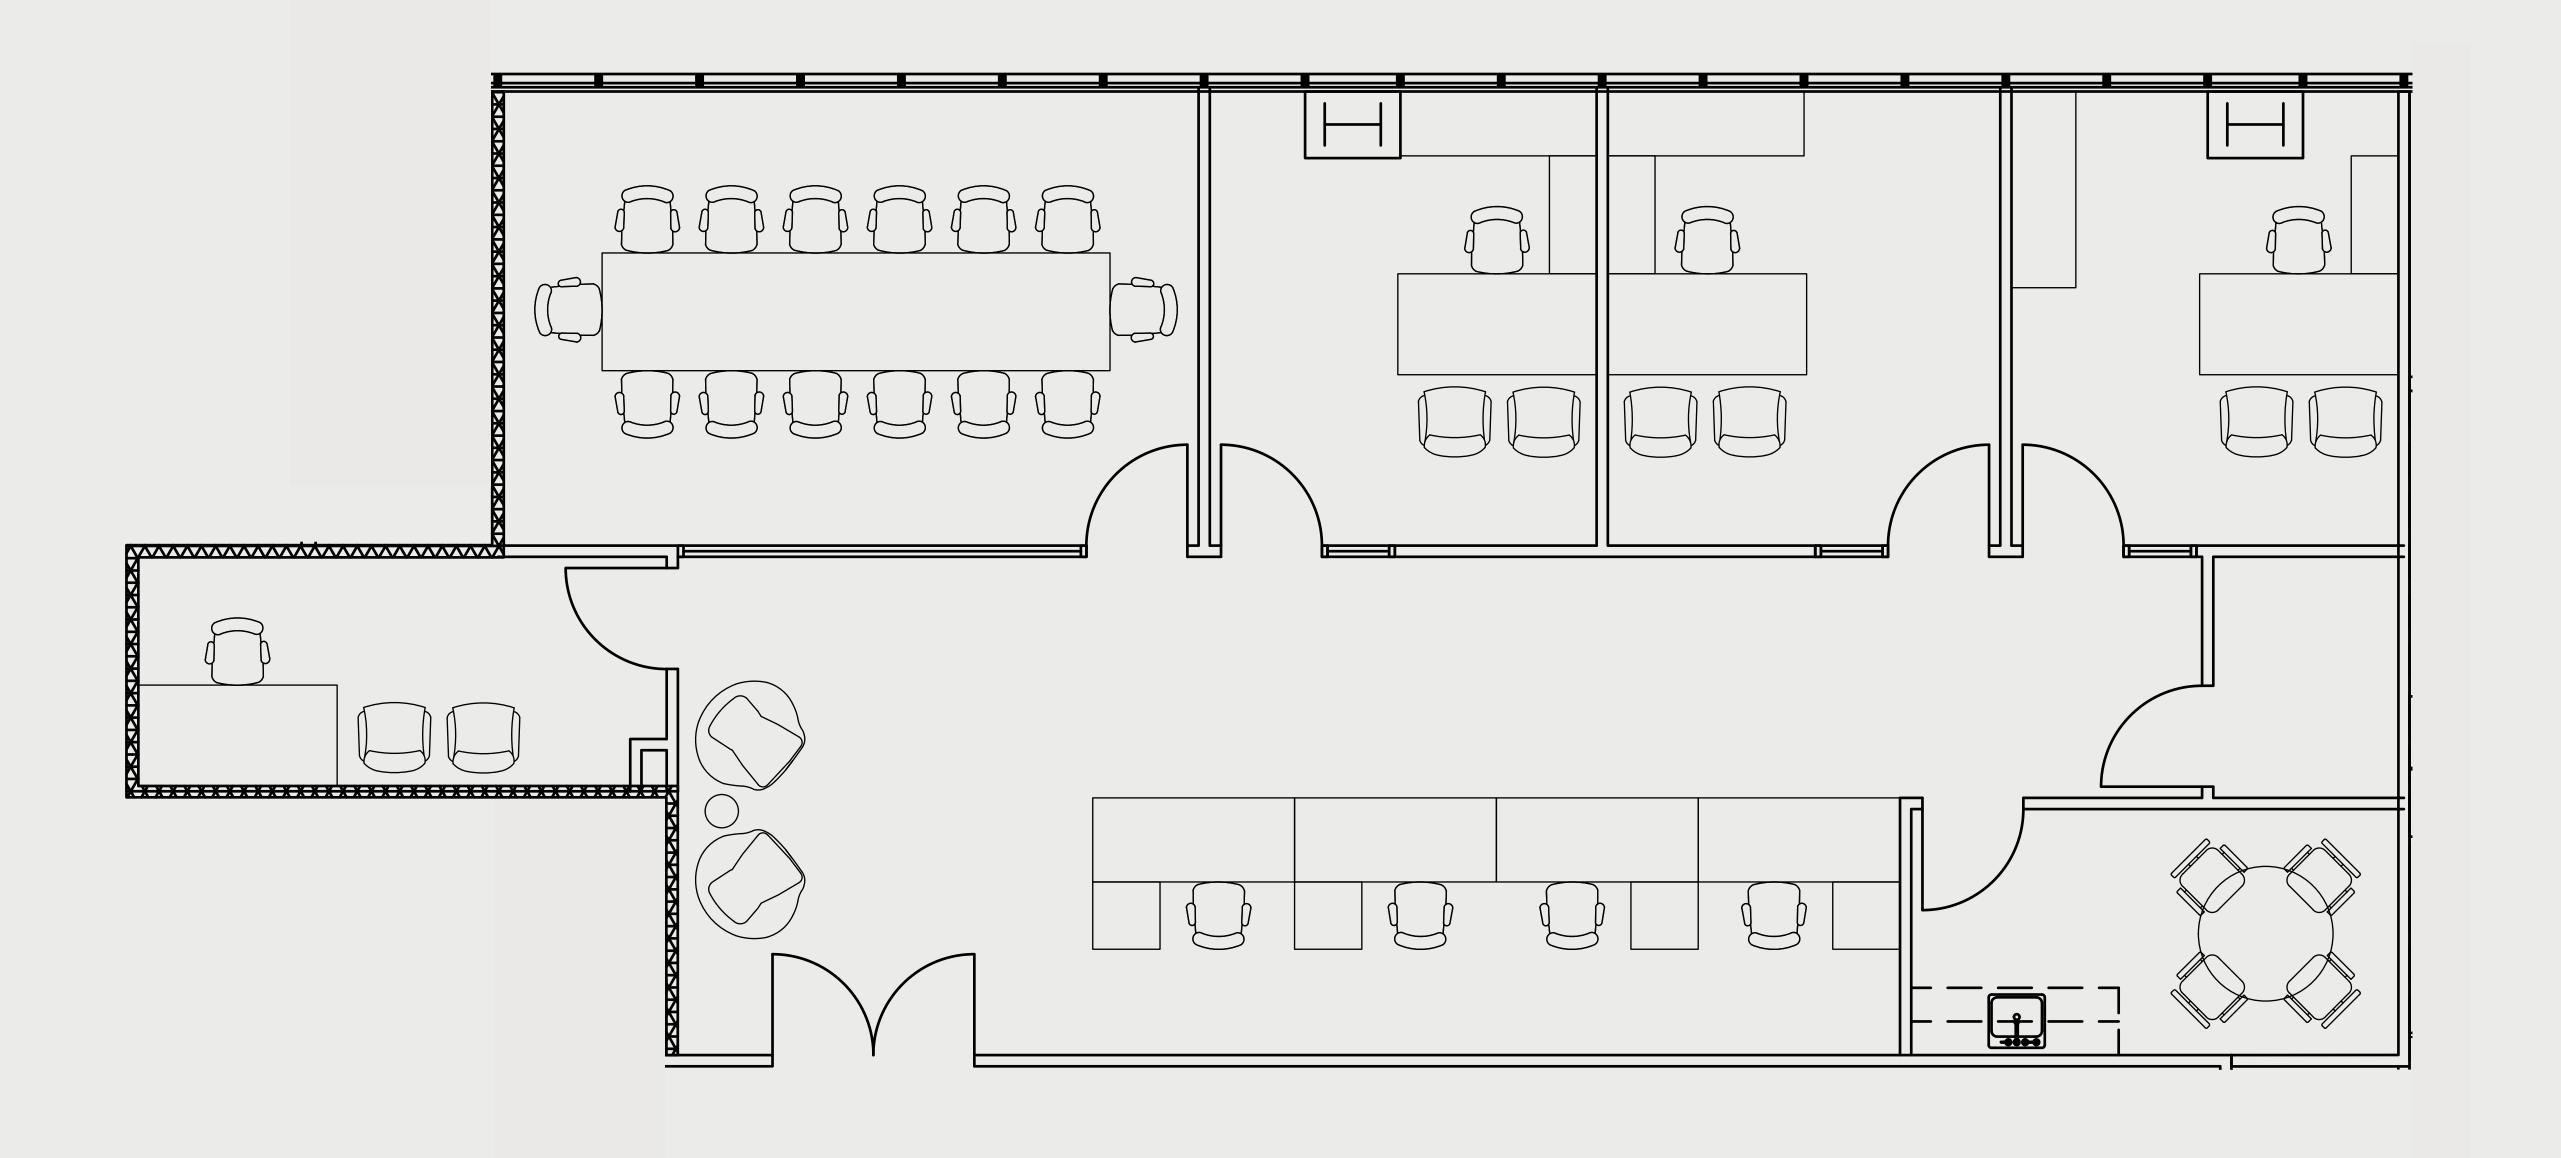

For leasing information please contact: USALEASING@ONNI.COM (213) 629-2041



