

SUITE: 500

 

RSF: 10,363



AS-BUILT CONFIGURATION

- OFFICES..... N/A
- RECEPTION..... N/A
- CONFERENCE ROOMS..... N/A
- KITCHEN..... N/A
- OPEN WORK AREA..... N/A

KEY PLAN:  
*Not to scale, furniture and appliances not included*

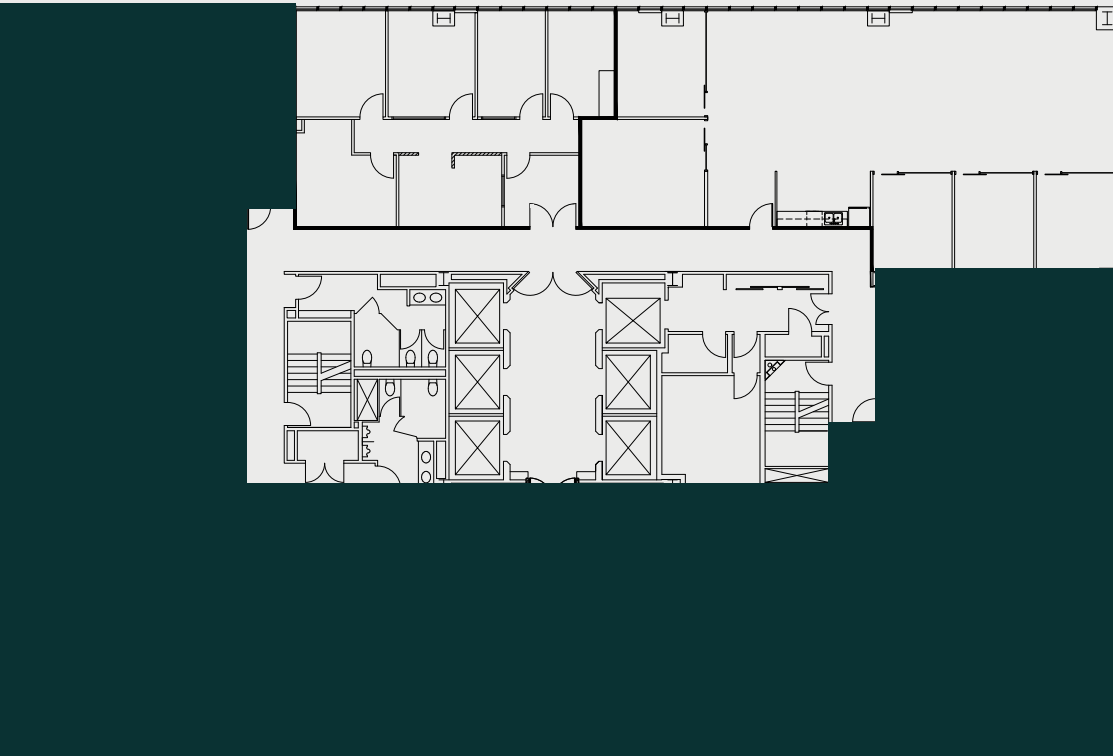

For leasing information please contact:  
USALEASING@ONNI.COM  
(213) 629-2041

