

SUITE: 808

RSF: 2,446





AS-BUILT CONFIGURATION

PRIVATE OFFICES.....	2
CONFERENCE ROOMS.....	1
KITCHEN.....	1
OPEN WORK AREA.....	+/- 9

Not to scale, furniture and appliances not included

KEY PLAN

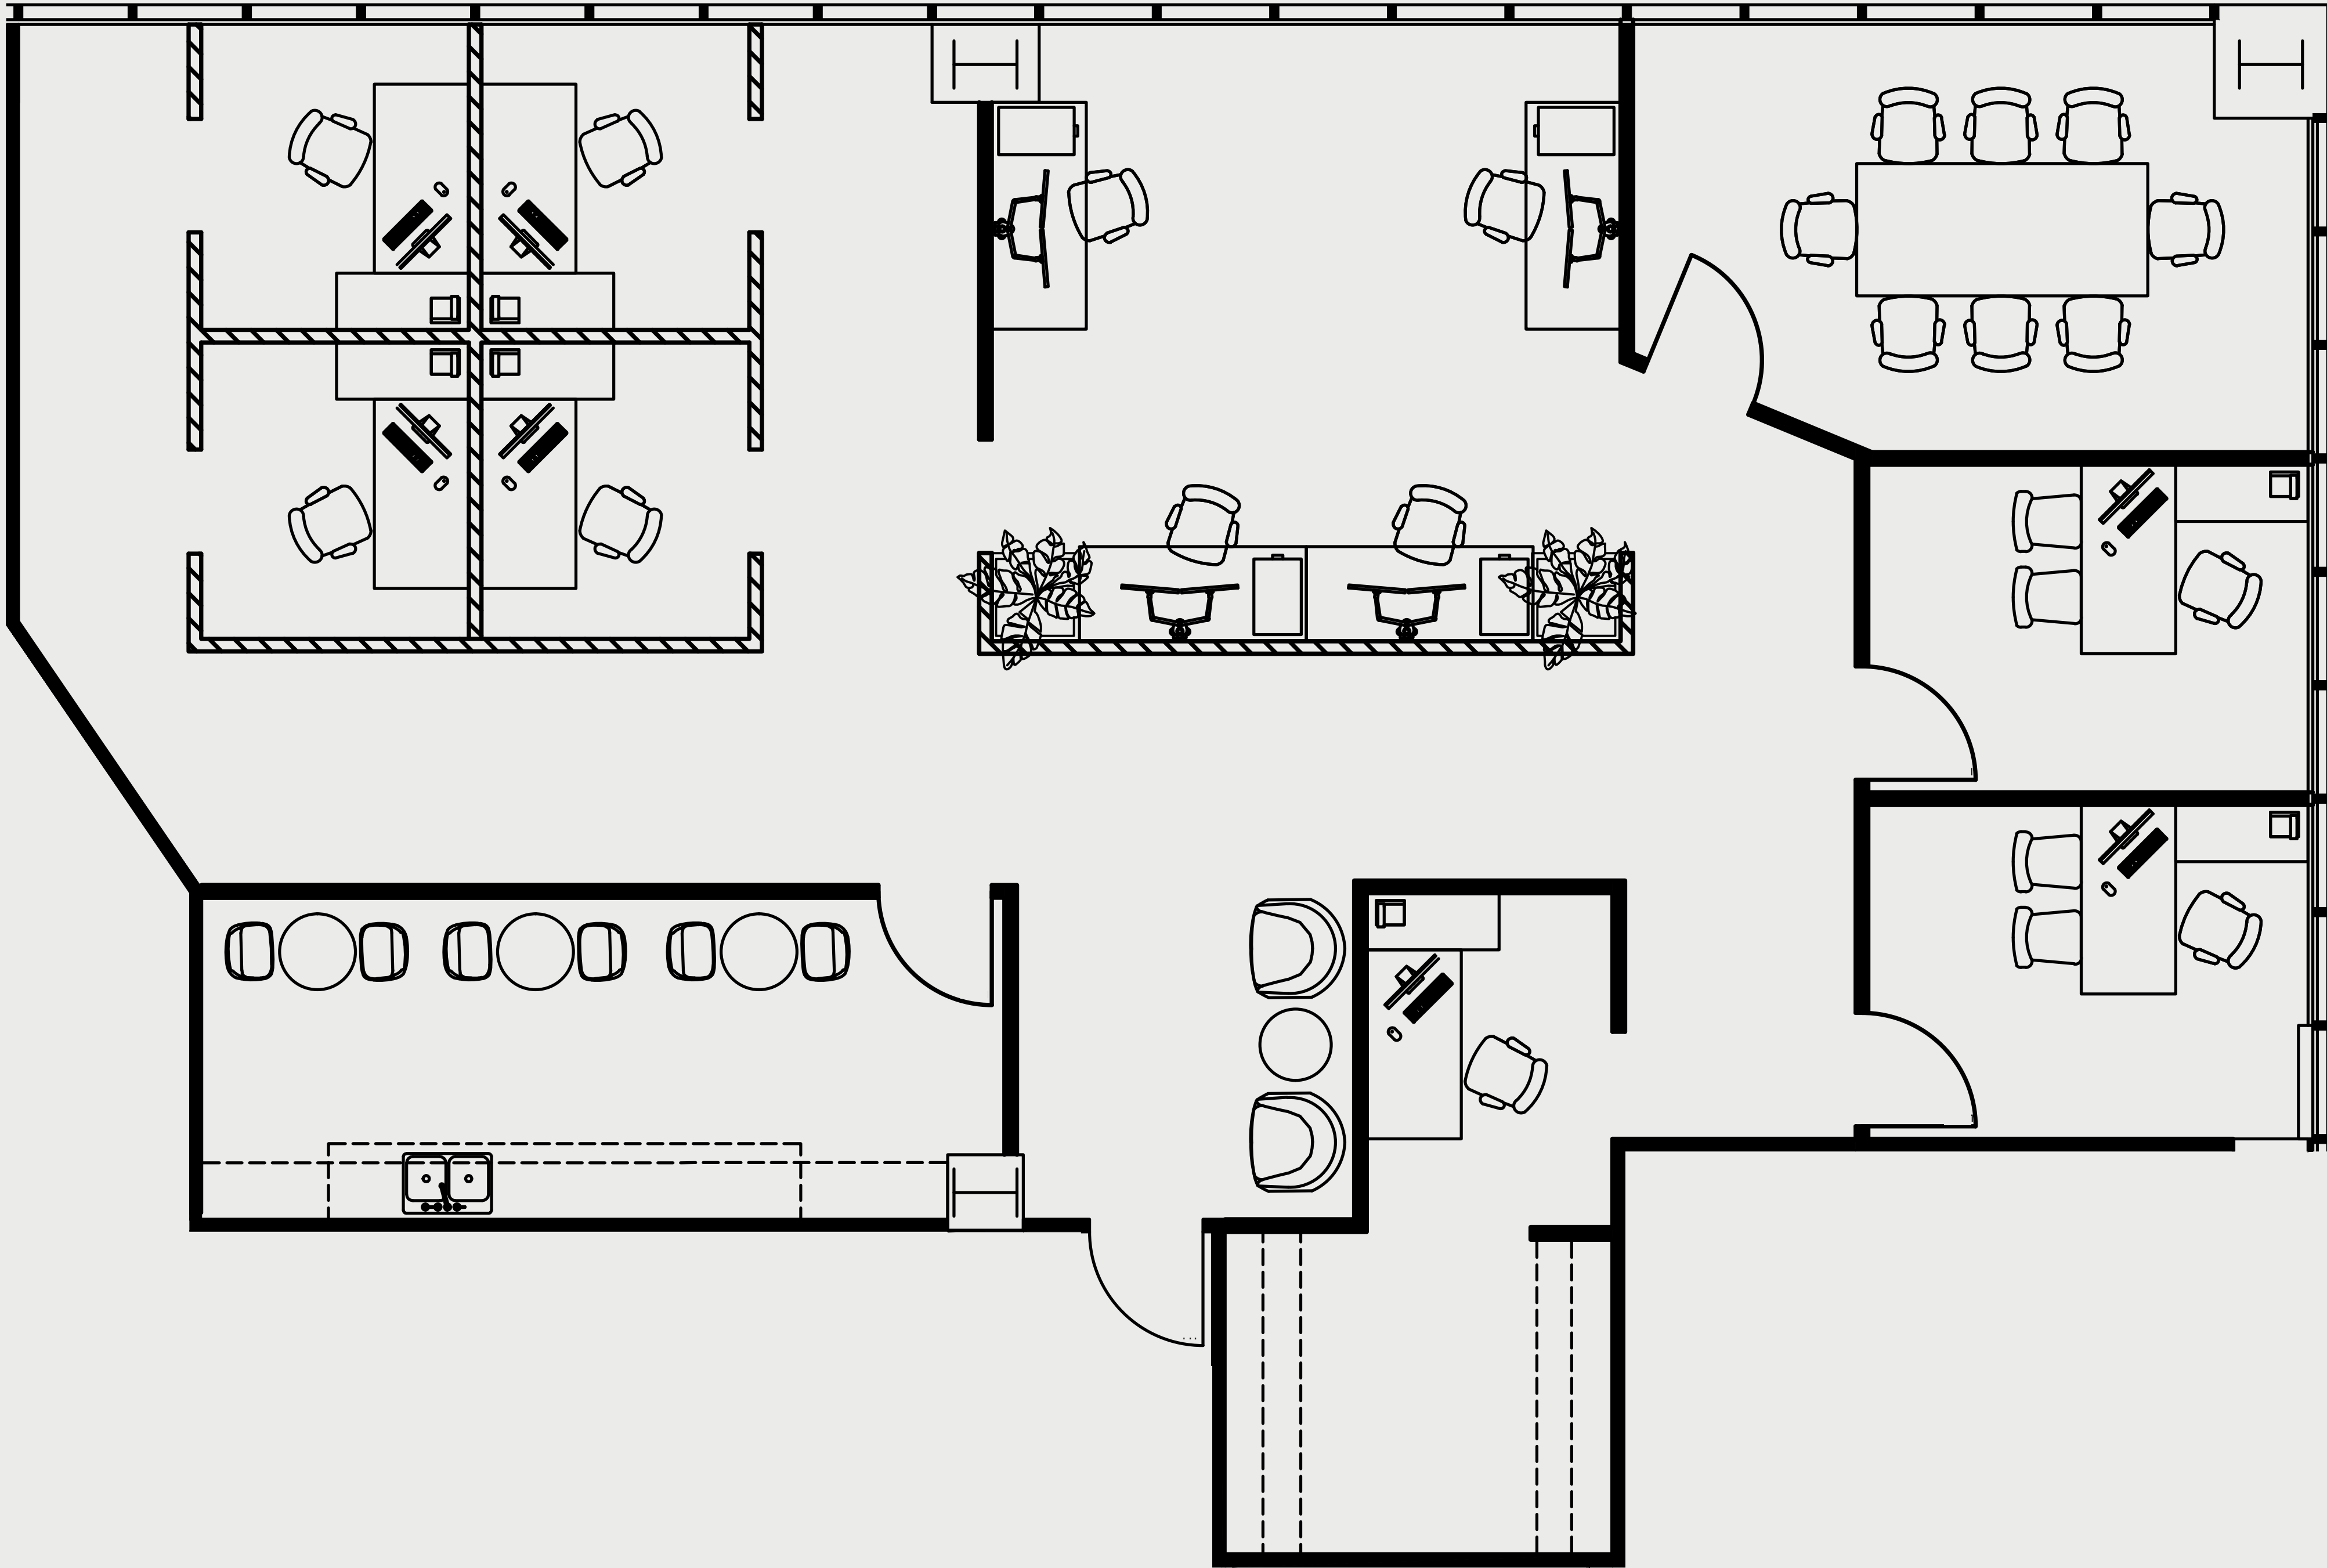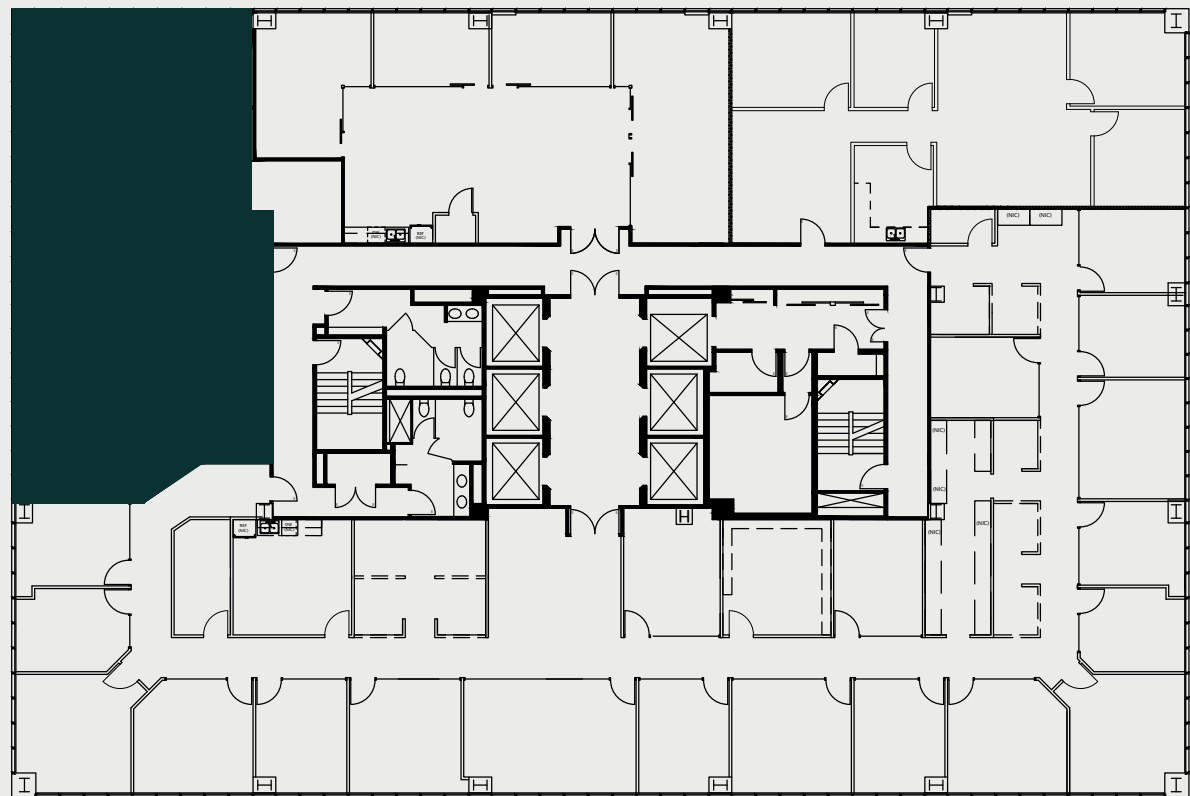

For leasing information please contact:
USALEASING@ONNI.COM
(213) 629-2041

