

# SUITE: 620



# RSF: 1,322

## AS-BUILT CONFIGURATION

OFFICES.....	2
RECEPTION.....	1
CONFERENCE ROOMS.....	1
KITCHEN.....	1
OPEN WORK AREA.....	+/-6

*Not to scale, furniture and appliances not included*

## KEY PLAN

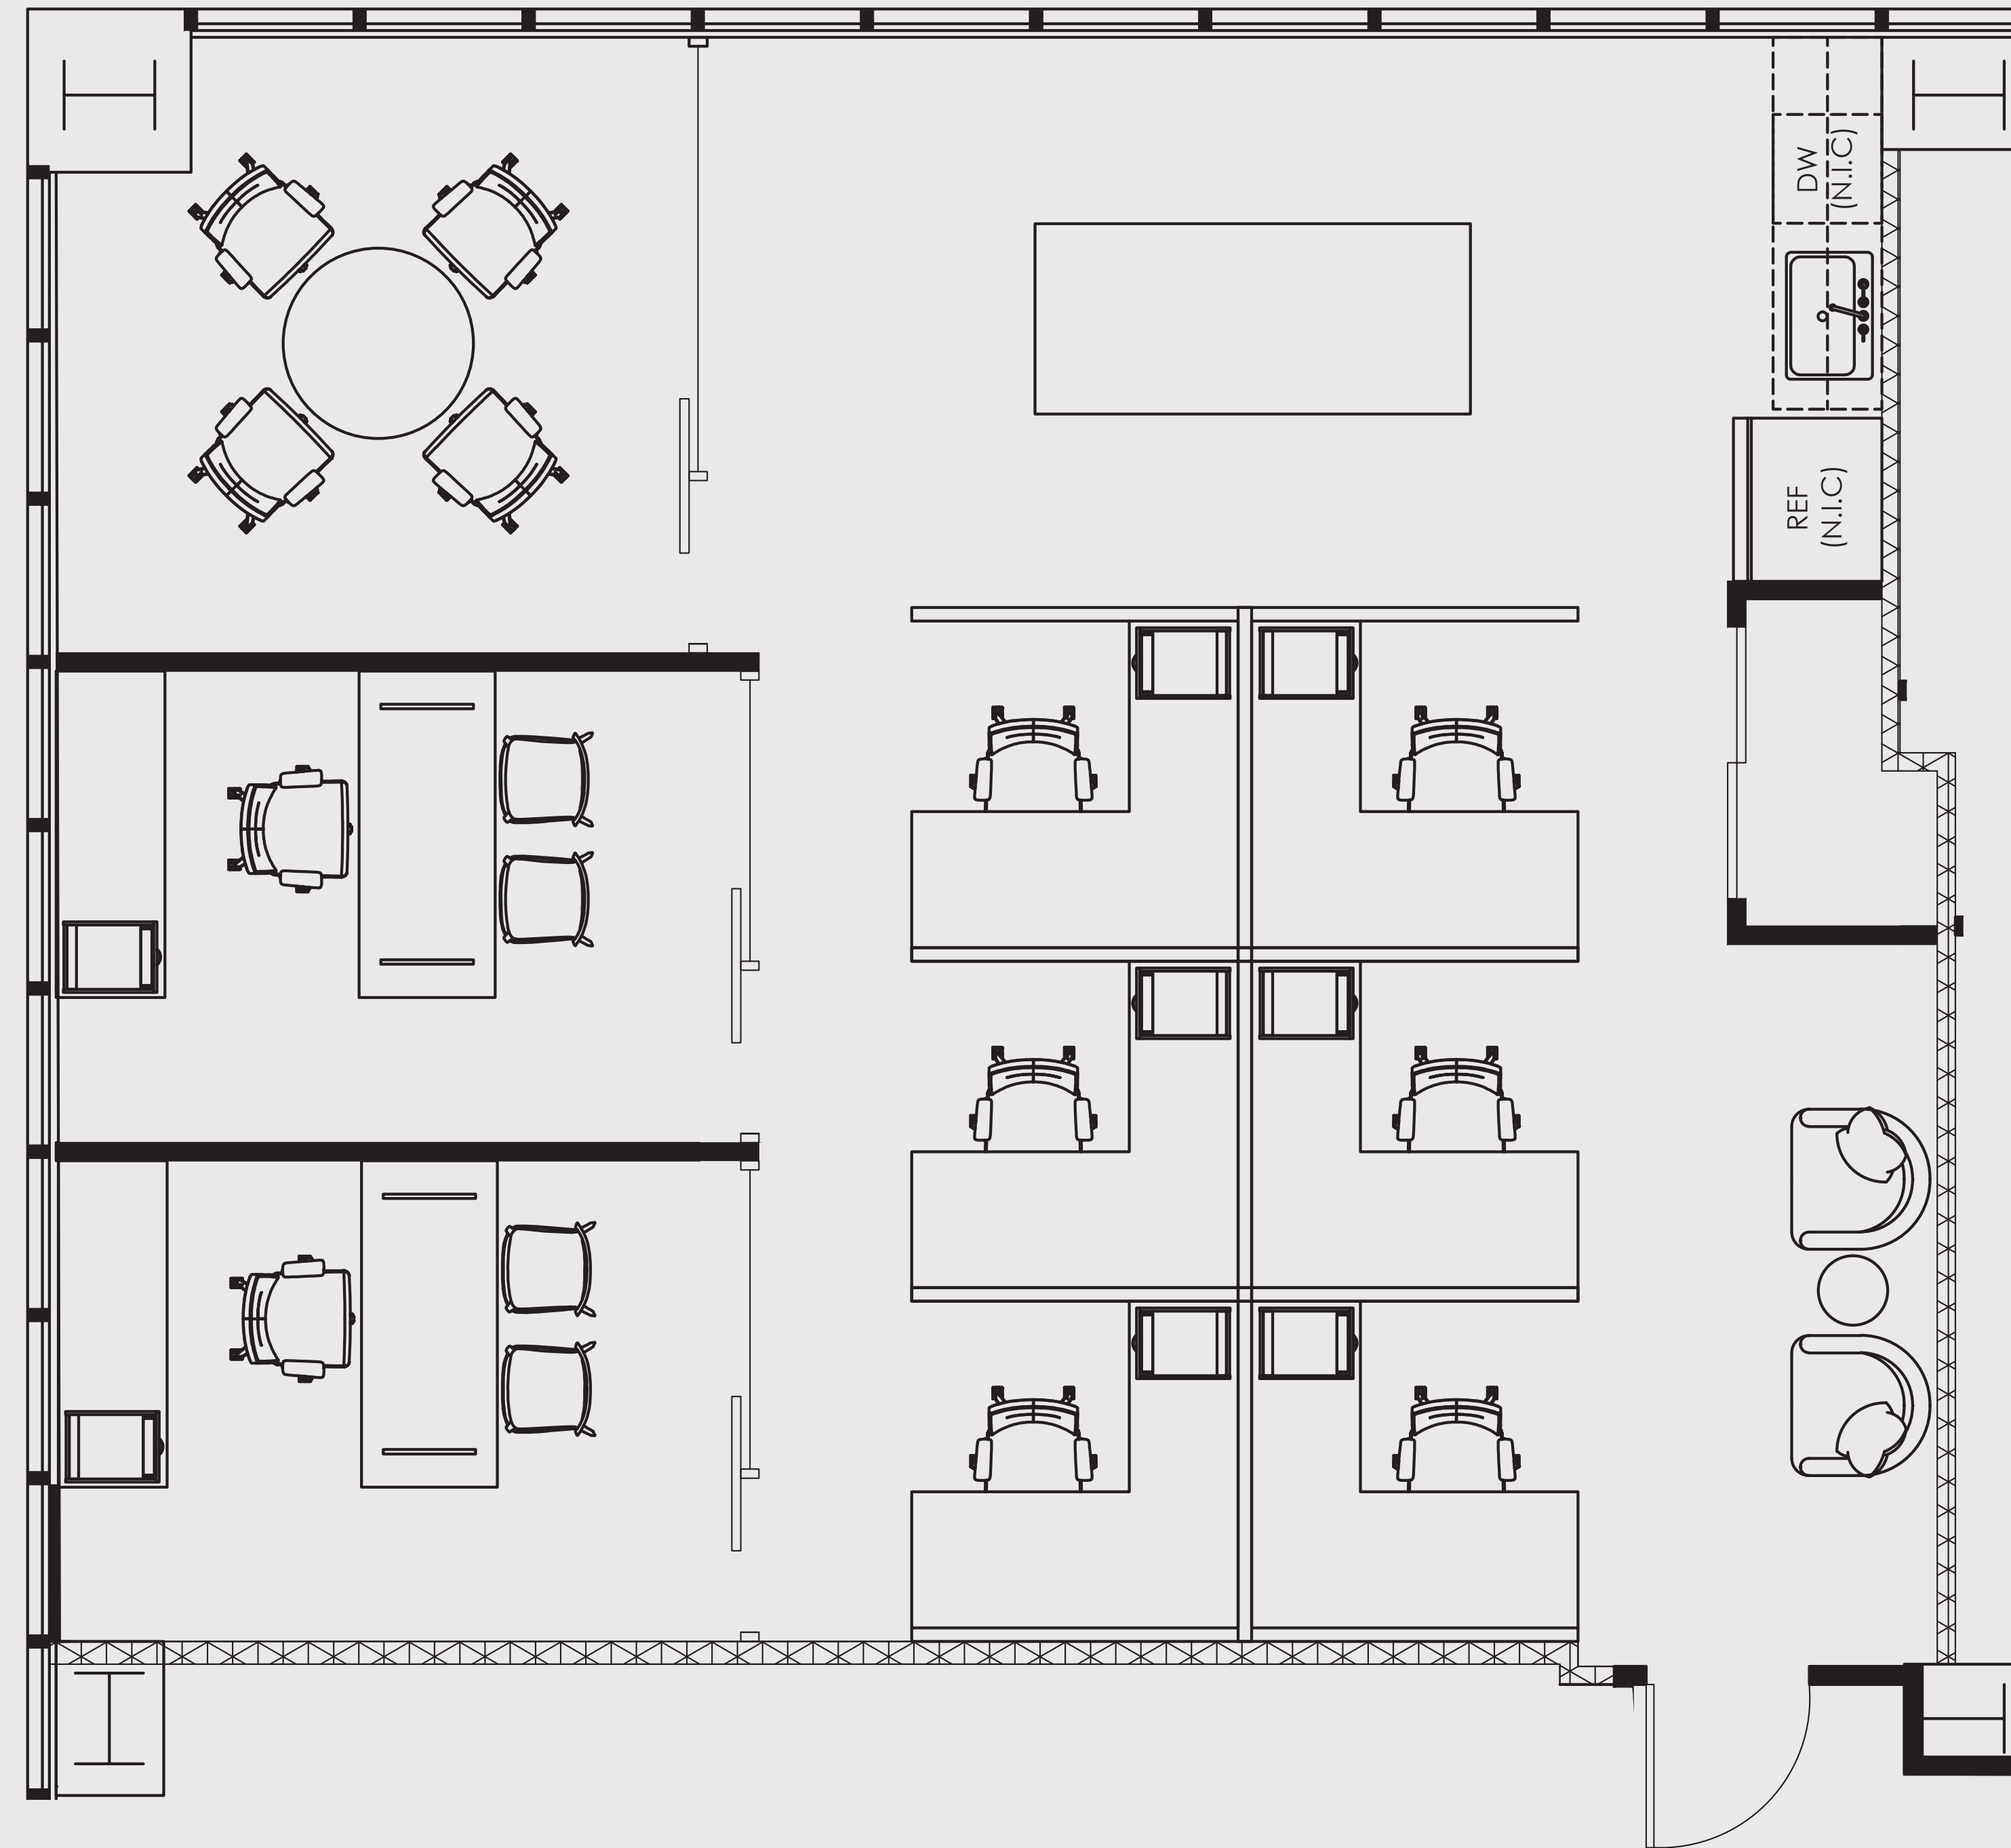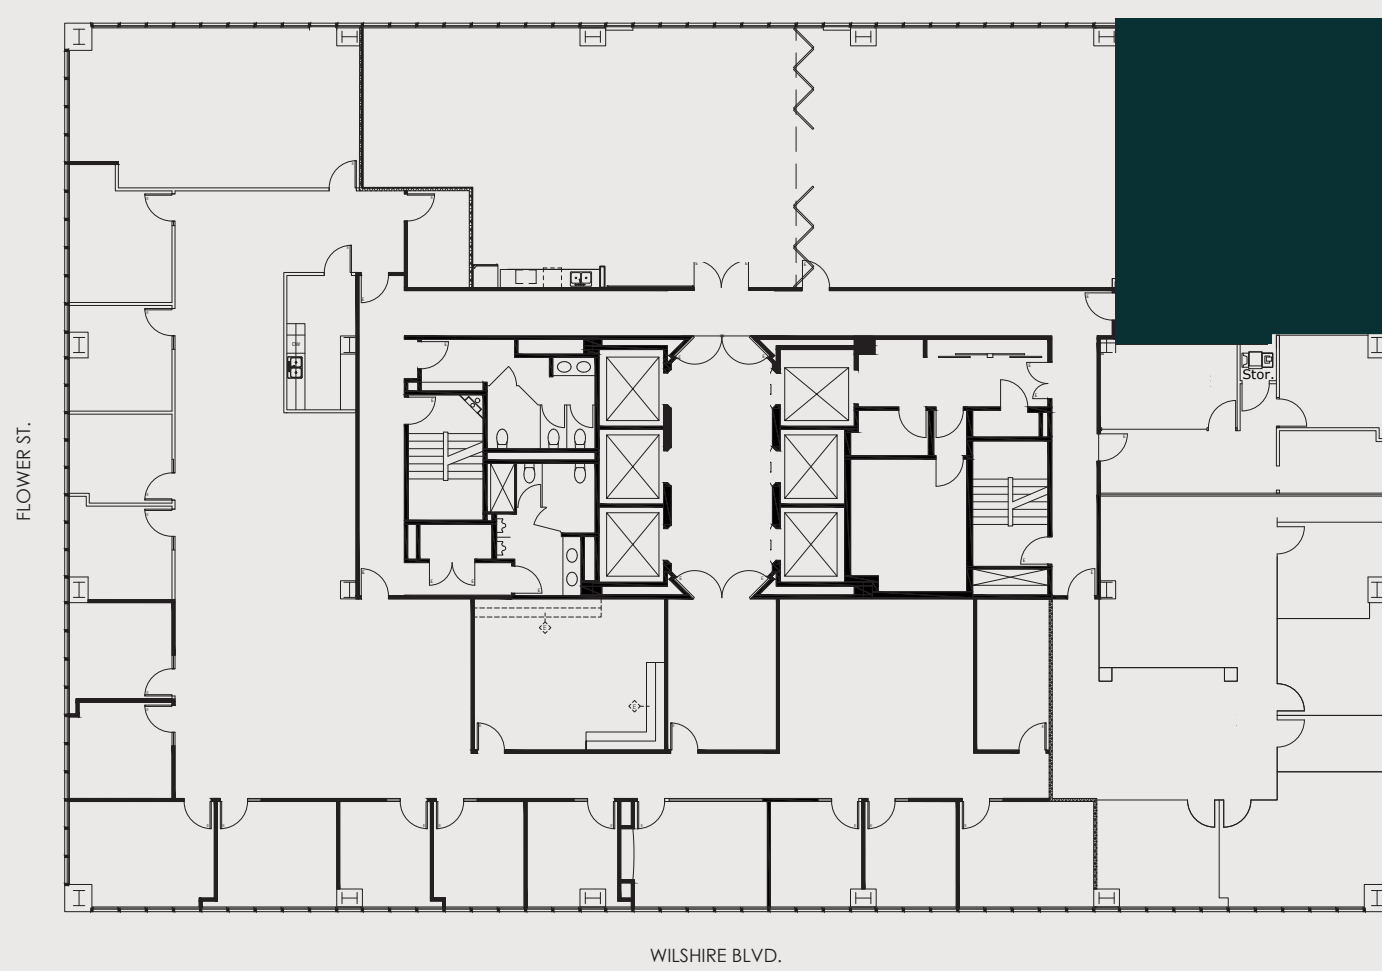

For leasing information please contact:  
USALEASING@ONNI.COM  
(213) 629-2041